

RFI/2022/272419 Asset Map near Camblesforth

Date created: 02/08/2022

NOTE
SITE BOUNDARY HAS BEEN UPDATED SINCE ORIGINAL CONSULTATION RESPONSE




www.environment-agency.gov.uk

Scale: 1:30,000



when reproduced @ A3

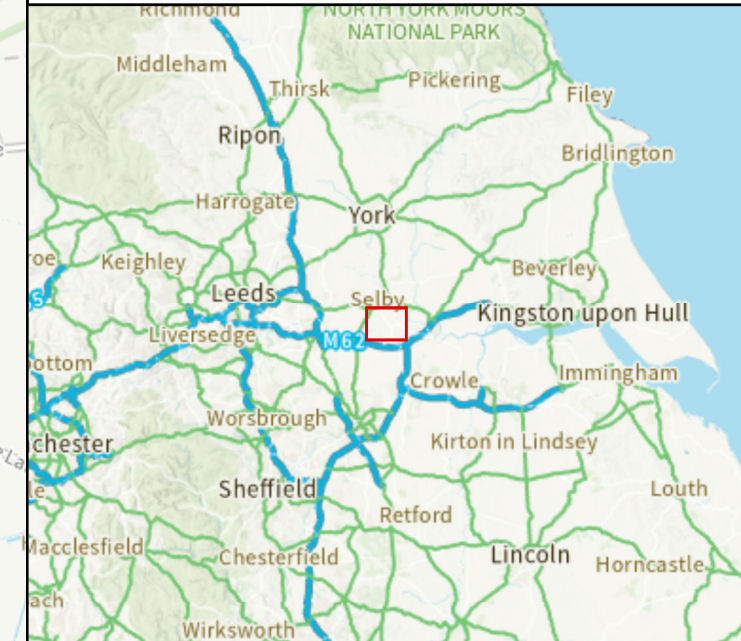

LEGEND

- Main River
- Site_Boundary
- Defences (EA maintained)**
- asset_sub_ Embankment
- asset_sub_ Spillway
- asset_sub_ Wall
- Defences (3rd party maintained)**
- asset_sub_ Bridge Abutment
- asset_sub_ Embankment

