

RFI/2022/272419 Historic Flood Map near Camblesforth

Date created: 02/08/2022

NOTE
SITE BOUNDARY HAS BEEN UPDATED SINCE ORIGINAL CONSULTATION RESPONSE




www.environment-agency.gov.uk

Scale: 1:30,000



when reproduced @ A3

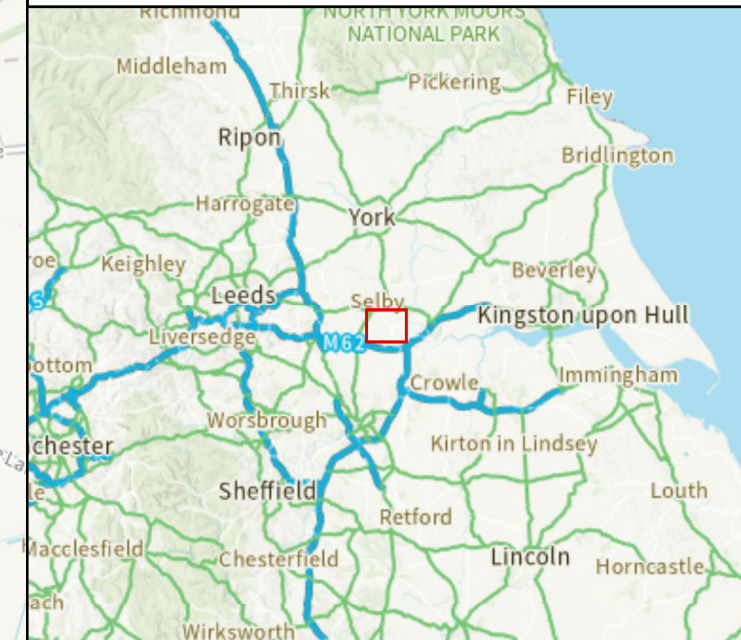

LEGEND

- Main River
- Site Boundary
- Recorded Flood Outlines**
- 2020 February Flood Incident - Storm Dennis
- 2020 February Flood Incident - Storm Ciara
- December 2015 Flood Event
- June 2007 Flood Event (Ridings Area)
- 123 Autumn 2000
- Autumn 2000 Event
- 123 Autumn 2000 - Lower Aire
- 123 Autumn 2000 - Gowdall
- Derwent March 1999 Event
- 123 February 1995 - Lower Aire
- 123 February 1995 - Lower Aire West Marsh
- 123 February 1995 - Lower Aire Hensall Ings
- 123 February 1995 - Rawcliffe
- 123 February 1995 - Lower Aire Heck Ings
- 123 February 1995
- 123 February 1995 - Lower Aire Eggborough Ings
- 123 February 1995 - Lower Aire Hirst Courtney Ings
- 1995 Flood Event
- 123 January 1982 - Lower Aire Eggborough Ings
- 123 January 1982 - Lower Aire Hensall Ings
- 123 January 1982 - Lower Aire
- 123 January 1982 - Lower Aire West Marsh